

BERSCH & ASSOCIATES LTD.

July 15, 2013

City of Saskatoon
Infrastructure Services Department
1101 Avenue P North
Saskatoon, Sk.
S7L 7K6

ATTENTION: Brent Anderson

SUBJECT: Fire Hall #4 - Asbestos Registry Report

Please find attached our laboratory's results for the bulk material samples taken from the Fire Hall #4 located at 2106 Faithful Avenue, Saskatoon, SK. The samples were analyzed in our laboratory for the identification of asbestos.

The results for the samples submitted were obtained by examination in accordance with the current USEPA 600/R-93/116 Method for the analysis of asbestos in building materials using polarized light microscopy and dispersion staining techniques. The detection limit of this method is listed as less than 1% by volume.

This test report relates only to the materials sent for examination and any use or extension of the information by the client of these results is the responsibility of the client. If any questions arise on the results of the attached information please contact our office. Thank you for this opportunity of service to your firm.

Included is a floor plan of the facility identifying the bulk sample locations. Photos of suspect materials sampled are also included following the floor plans.

Sincerely,

Dustin Fraess
Bersch & Associates Ltd.
File: B67BLE03

Bersch & Associates Ltd.

Box 3568

Humboldt, Sask. S0K 2A0

PROJECT NO. B67.13**CLIENT: City of Saskatoon****Infrastructure Services - Facilities Branch****Contact: Brent Anderson****Location: Fire Hall #4 - 2106 Faithful Avenue, Saskatoon, SK.**

B67BAE03

BULK SAMPLE ANALYSIS REPORT

NO.	DATE	SAMPLE INFORMATION	ASBESTOS	%	ANALYST
B1	3-May-13	B01 Mechanical - Lineal pipe insulation on a green line adjacent east wall	None detected		WB
B2	3-May-13	B01 Mechanical - Ducting Insulation on fresh air duct adjacent entry	None detected		WB
B3	3-May-13	107 - Sheet flooring- tan, white, green and grey stone pattern	None detected		WB
B4	3-May-13	109 - Ceiling plaster above the suspended ceiling	None detected		WB
B5	3-May-13	107- 2' by 4' Ceiling tile	None detected		WB



City of Saskatoon

Infrastructure Services
Department

Facilities Branch
300-876-3300

GENERAL NOTES:

1. All dimensions are in millimetres
2. Drawings are not to be scaled.
3. All drawings to be read in conjunction with the specifications.
4. Where otherwise noted, work shall conform to the current edition of the Saskatchewan Building Code and the start of construction.
5. Report all discrepancies to the Consultant.
6. If in doubt, ask.

REV. ISSUED FOR DATE

DESIGNED BY: DRAWN BY: CHECKED BY:


SCALE: 1:100

SHEET NAME: Lower Floor Base Plan

PROJECT TITLE: 824 Firehall #4

PROJECT NO. SHEET NO. 824


REV. NO.

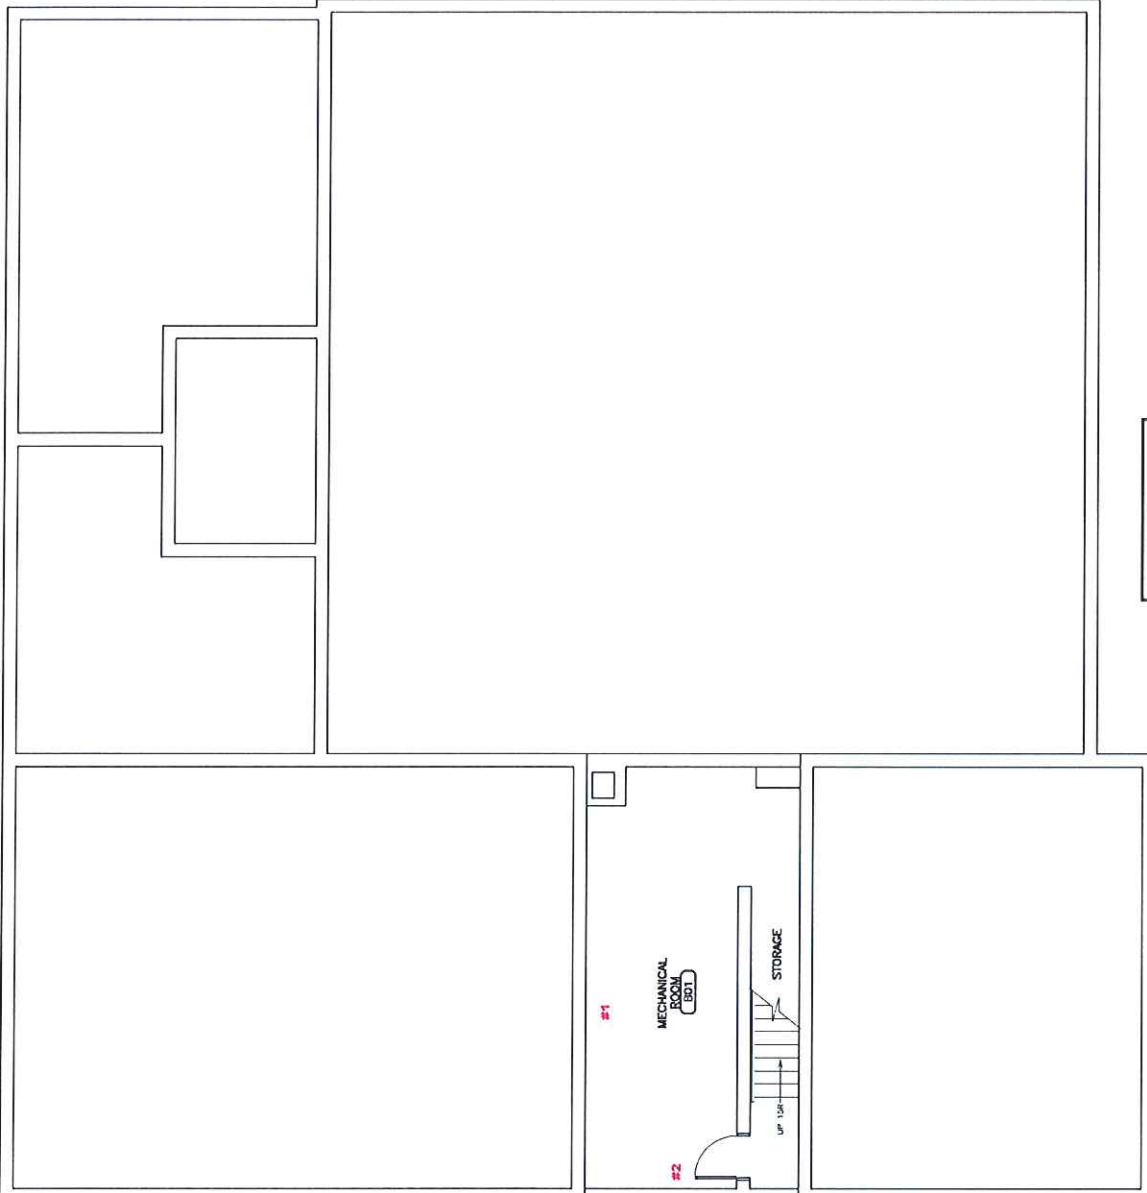

- Sample # Location

- GENERAL NOTES:
1. All dimensions are in millimetres.
 2. Drawings are not to be scaled.
 3. All drawings to be read in conjunction with the specifications.
 4. Where otherwise noted, dimensions are to the face of the work.
 5. Report all discrepancies to the Consultant.
 6. If in doubt, ask.

REV	ISSUED FOR	DATE
DESIGNED BY	DESIGNED BY	DESIGNED BY
SCALE	DATE	14/2/2005
PROJECT NAME	Asbuilt	
Main Floor Base Plan		
PROJECT TITLE	824 Firehall #4 2106 Faithfull Ave.	
PROJECT NO.	SHEET	REV. NO.

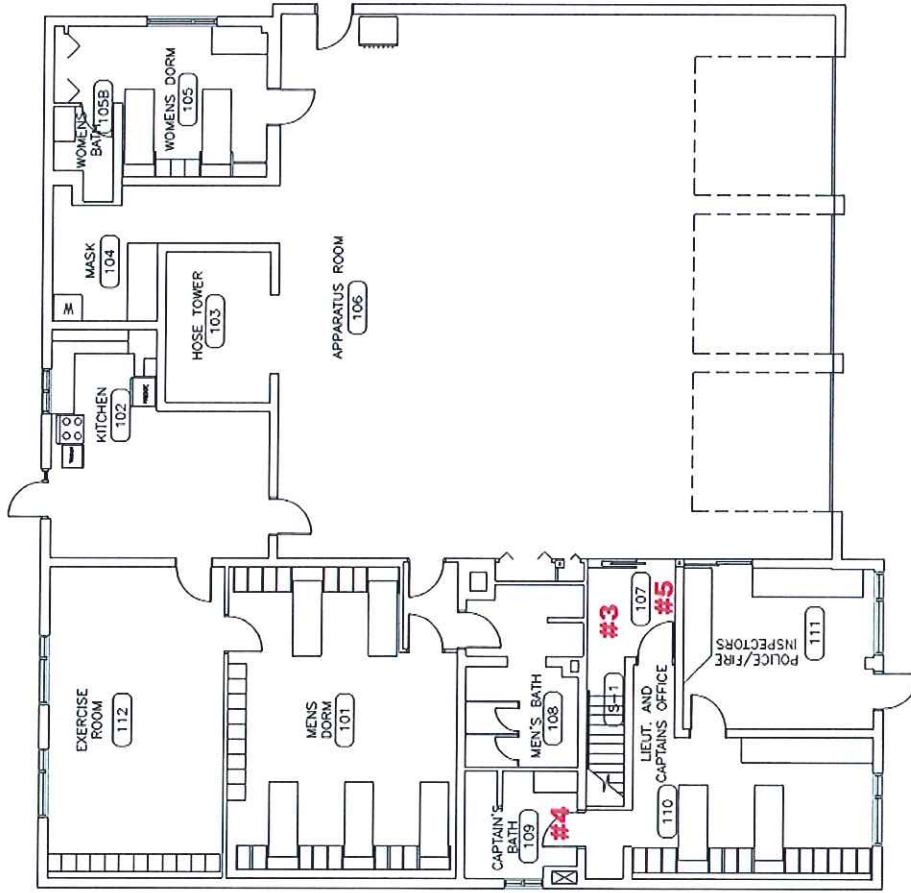

#_ - Sample # Location

BULK SAMPLE PHOTOS

#1) Pipeline Insulation




#2) Ducting Insulation



#3) Sheet Flooring



#4) Ceiling Plaster

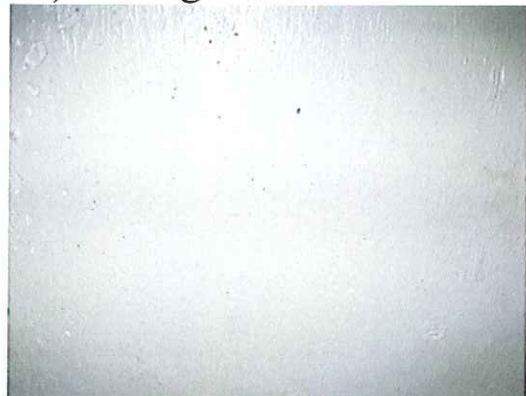

#5) 2' x 4' Ceiling Tile

